




-
- A hand-drawn cross-section diagram of a road and ditch. The road is on the right with a 2% downward slope. A ditch is on the left. Dimensions include 5.0' for the road width, 1.0' for ditch width, and 2.5' for ditch depth. A 2.5% slope is indicated for the ditch bottom. The diagram is labeled "ELEVATION" and "NO SCALE".

CHECK DAM
DETAILS

CHECK DAM NOTES

-


SECTION A-A
NO SCALE

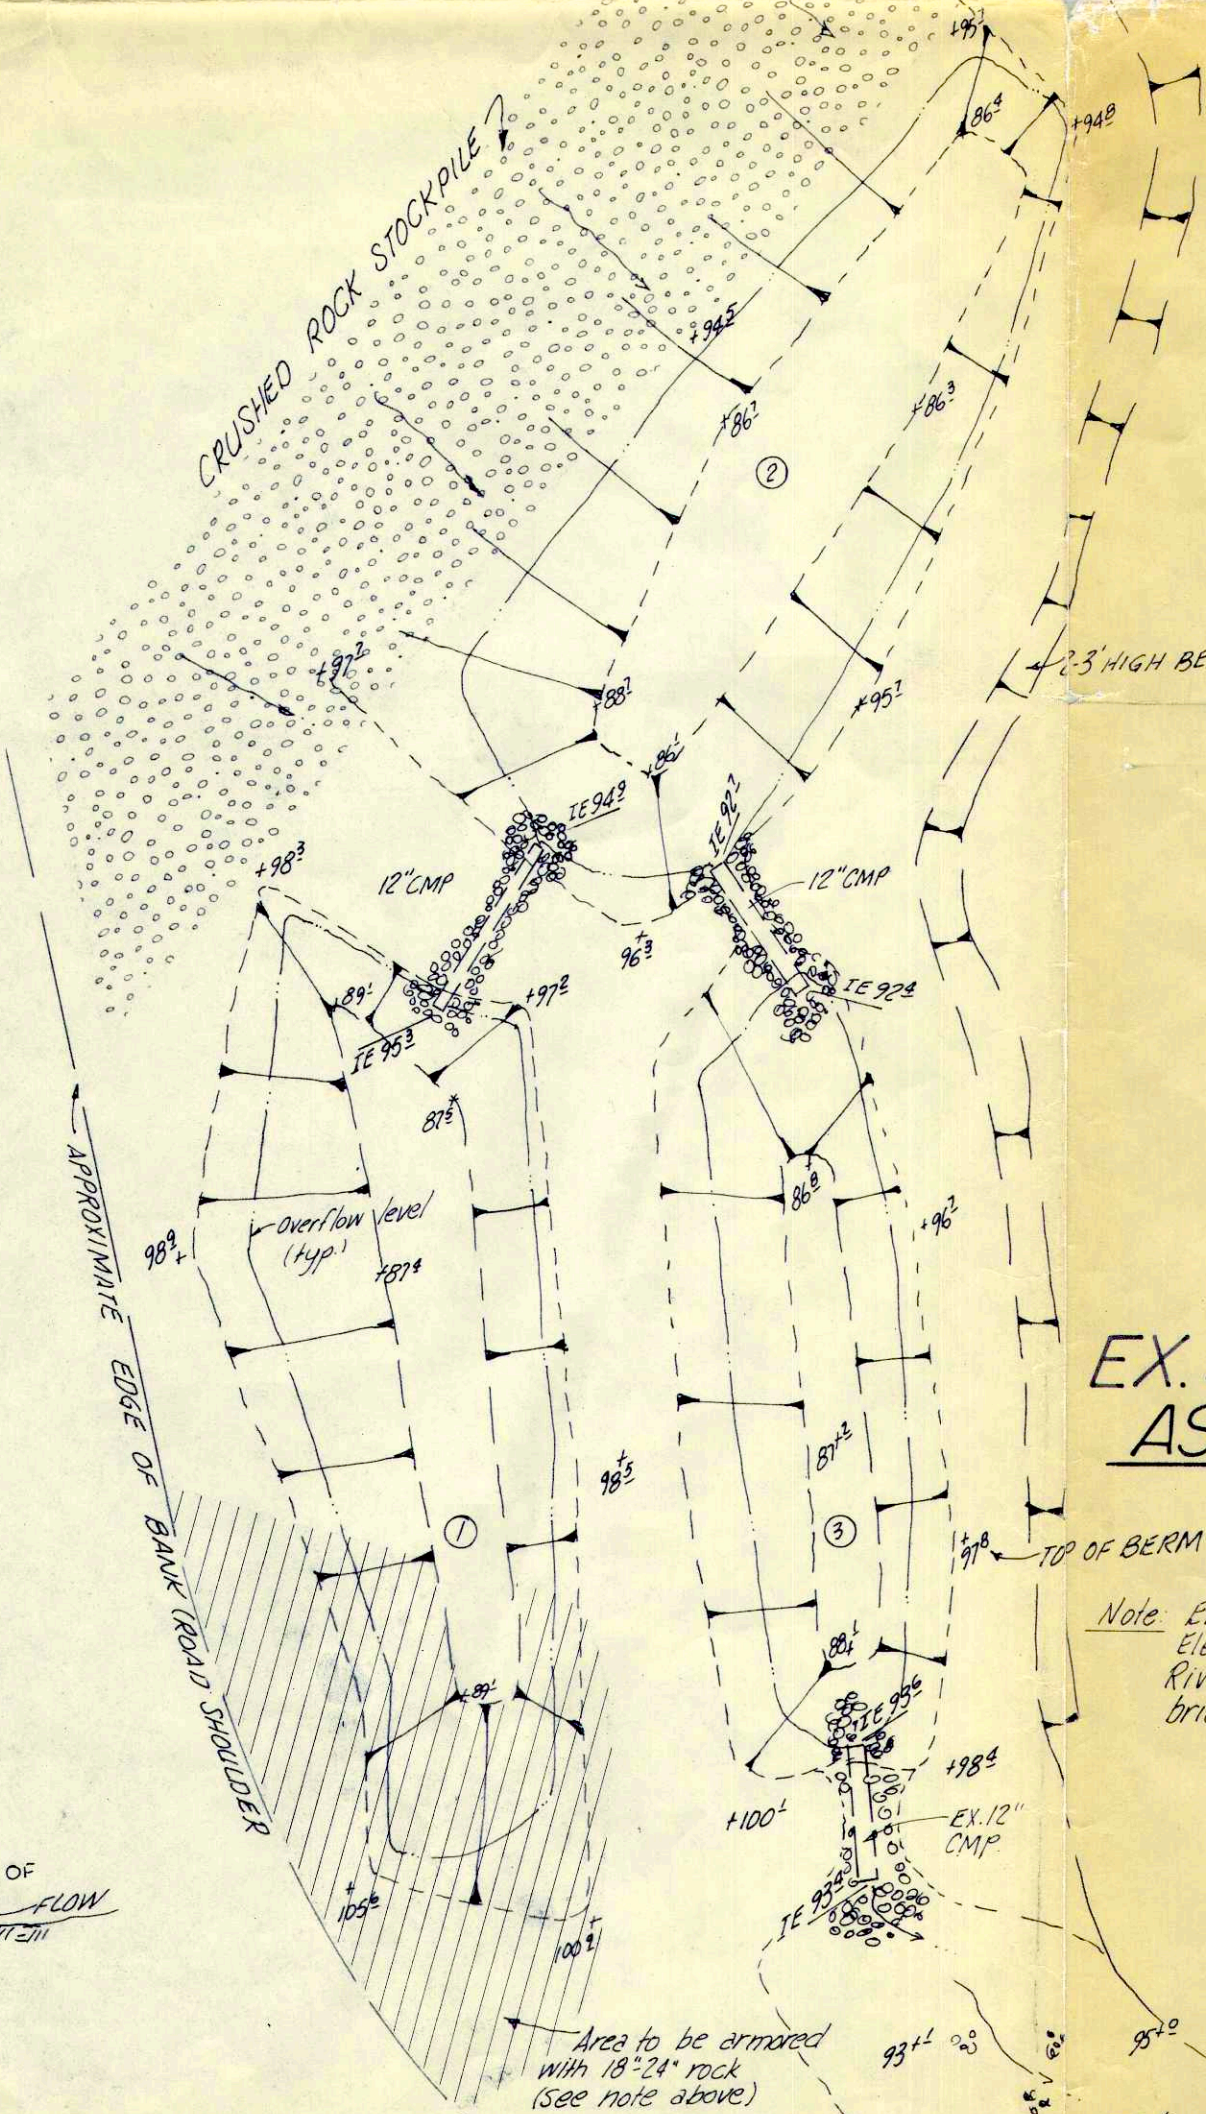

STORMWATER DRAINAGE PLAN NOTES

- SURFACE WATER
MANAGEMENT DIVISION
APPROVAL 

* ANY Future permits for this site or renewals of this permit application MUST provide a DETAILED (MIN. 5' contour INTERVAL) Topographic survey. THIS SURVEY SHOULD show all "as-built" slopes within the existing mining areas, and ANY LOCATIONS for WHICH ADDITIONAL WORK MAY BE PROPOSED UNDER THE PERMIT/ Renewal Application

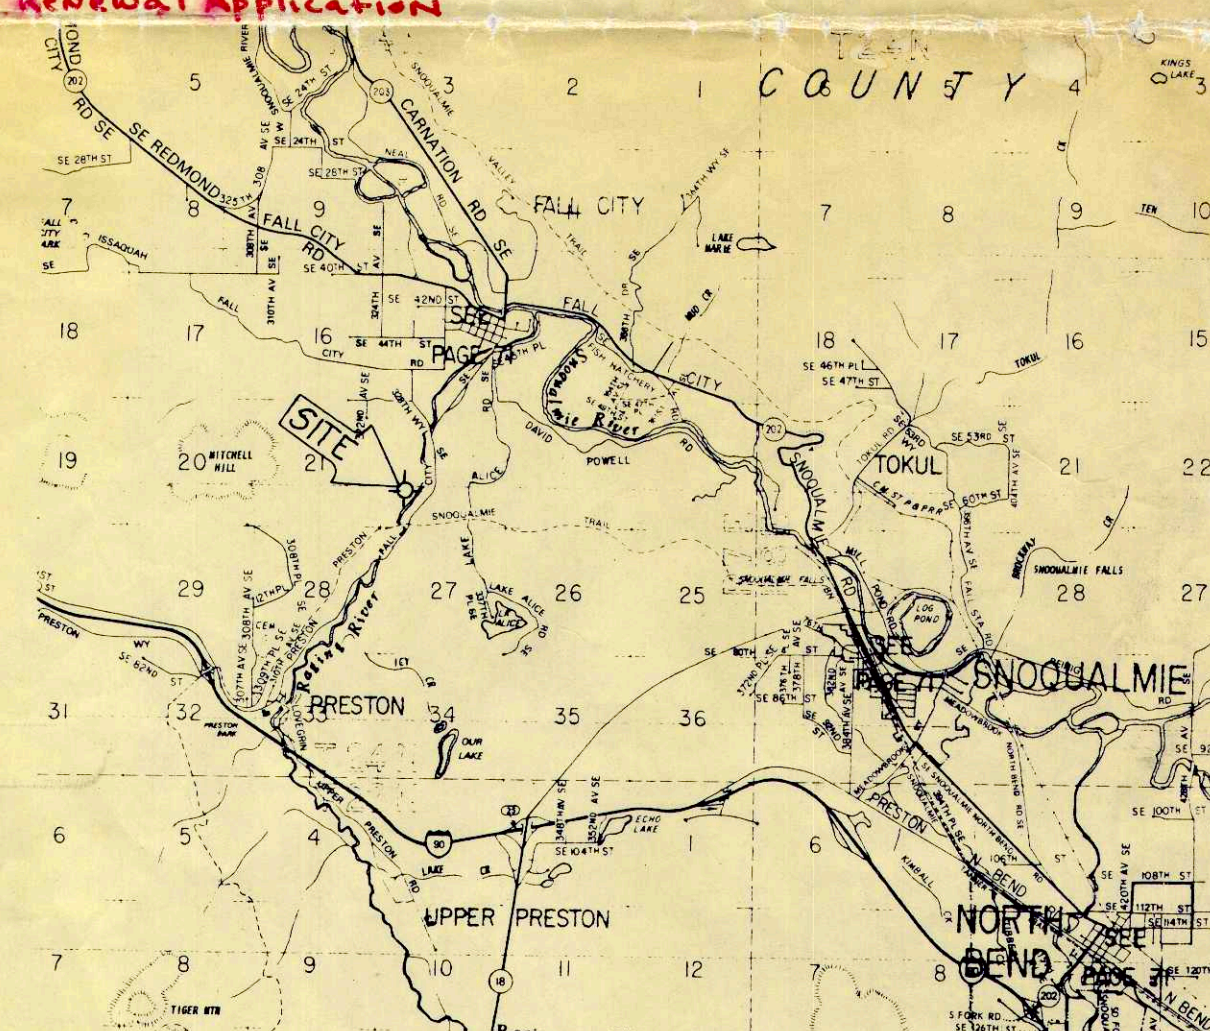


VICINITY MAP

EX. SEDIMENT PONDS,
ASBUILT (1"=20')

2	2-2-83	Add details per K.C. instructions	B.J.D.
1	1-23-83	Complete revision per K.C. instructions	B.J.D.
REV	DATE	DESCRIPTION	BY

RAGING RIVER MINING COMPANY
P.O. BOX 691
REDMOND, WASHINGTON 98052
RAGING RIVER QUARRY
EROSION/SEDIMENT CONTROL PLAN

(206) 454-3743 OR 885-7877

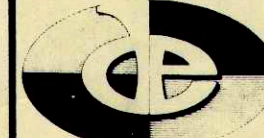

DODDS ENGINEERS, INC.

1850-130TH AVENUE NORTHEAST
BELLEVUE, WASHINGTON 98005

OWN <i>B.I.D.</i>	BOOK	PROJ. NO
-------------------	------	----------

SVD DATE 82114

SVS DATE

APPD SAT 10

B.A.L.C